

APR 24 2017

VERIFICATION FORM FOR COMMUNITY PUBLIC WATER SYSTEMS CLAIMING NO LEAD SERVICE LINES

The owner or operator of all community public water systems must identify and map areas of their distribution system that are known or are likely to contain lead service lines. Systems must submit a copy of the applicable map to the Ohio Department of Health and the Ohio Department of Job and Family Services. Systems must also submit a report to the director containing at least both of the following: (1) The applicable map with narrative, and (2) A list of sampling locations used to collect samples as required by Ohio Revised Code (ORC) Section 6109.121 and any rules adopted thereunder, including contact information for the owner and occupant of each sampling site.

Should a water system determine no lead service lines exist in their distribution system, they must provide information stating they reviewed, at the minimum, historical permit records and local ordinances, distribution maintenance records and information pertaining to installation dates or materials for all services lines. This information must be verified below.

I HEREBY CERTIFY THAT THE FOLLOWING METHOD(S) WERE USED TO DETERMINE NO LEAD SERVICE LINES EXIST IN THIS WATER SYSTEM'S DISTRIBUTION SYSTEM, AS REQUIRED BY ORC 6109.121(F):

LEAD SERVICE LINE VERIFICATION	
<p>This PWS states they have no lead service lines and has reviewed the following information (select one or more of the following):</p> <ul style="list-style-type: none"> <input type="checkbox"/> Historical permit records and/or local ordinances <input checked="" type="checkbox"/> Distribution maintenance records (i.e. meter replacement, waterline break repairs) <input checked="" type="checkbox"/> Information pertaining to installation dates for all service lines (i.e. after 1986 when lead services lines were banned) <input type="checkbox"/> Service line material of all service lines is known (i.e. all service lines are known to be PVC) 	

 4/20/17
 Signature of Responsible Person Date

RANDY DANFORD Superintendent
 Printed Name and Title of Responsible Person

PWS NAME: Village of Smithville
 PWS ID: OH 8503512
 COUNTY: WAYNE

<p>For Ohio EPA use only:</p> <p>Date Verification Rec'd: _____</p>
--

Entity: _____
 Doc Type: Report
 Doc Subtype: Lead Mapping
 Program: DDAW
 County: Wayne
 Secondary ID: OH 8503512

Add to eDoc 586671

4/20/17
Village of Smithville
PWS # OH 8503512

Buildings in Ohio built prior to 1998 or that use plumbing material or solder manufactured before 1998 may have materials with greater than 8% lead and are at a higher risk of contributing lead to the drinking water than materials manufactured after 1998. In addition, buildings built and plumbing materials manufactured after 2014 were required to have less than 0.25% lead by weight and have the lowest risk for contributing lead to the drinking water. It should be noted however that, although prohibited, some use of lead solder or leaded components may have occurred after the prohibitions became effective.

RECEIVED

APR 24 2017

OHIO EPA NEDC

Water Line Sizes

4" Lines

W. Prospect- 4" (mechanical)
E. Prospect- 4"
Parkview & Parkview circle- 4"
Dawn Dr.- 4"
Eldorado- 4"
Jane Dr.- 4"(switches to 6" at last hydrant goes to
Carter Grove)
David- 4"
Dan St.- 4"
Dennis Cr.- 4"
S. Mill St.- 4"

6" Lines

S. Milton St.- 6"
N. Milton St.- 6"
Carter Grove- 6"
Charles Ave.- 6"
Fairlawn Ave.- 6"
N. Mill St.- 6"
Gilbert Dr.- 6" (private)
WCSCC- 6" (private)
Barn Rest.- 6"(private)

8" Lines


East & West Center St.- 8"
Northeast St.-8"
Weller Dr.- 8"
Moss Creek St.- 8"
Gable Ln.- 8"
Kauffman Dr.- 8"
Smithie Dr.- 8"(private)
Red Barn at Barn Complex- 8"(private)

12" Lines

Loop around Square- 12"
Main St.- 12"
North & South Summit- 12"

2" Lines

E. Main From Leepers to Cemetery- 2"
Eberly- 2"
Hooley- 2"
Franklin Court- 2"
Church St.- 2"(6" stub at main)
Parkview to S. Milton- 2"

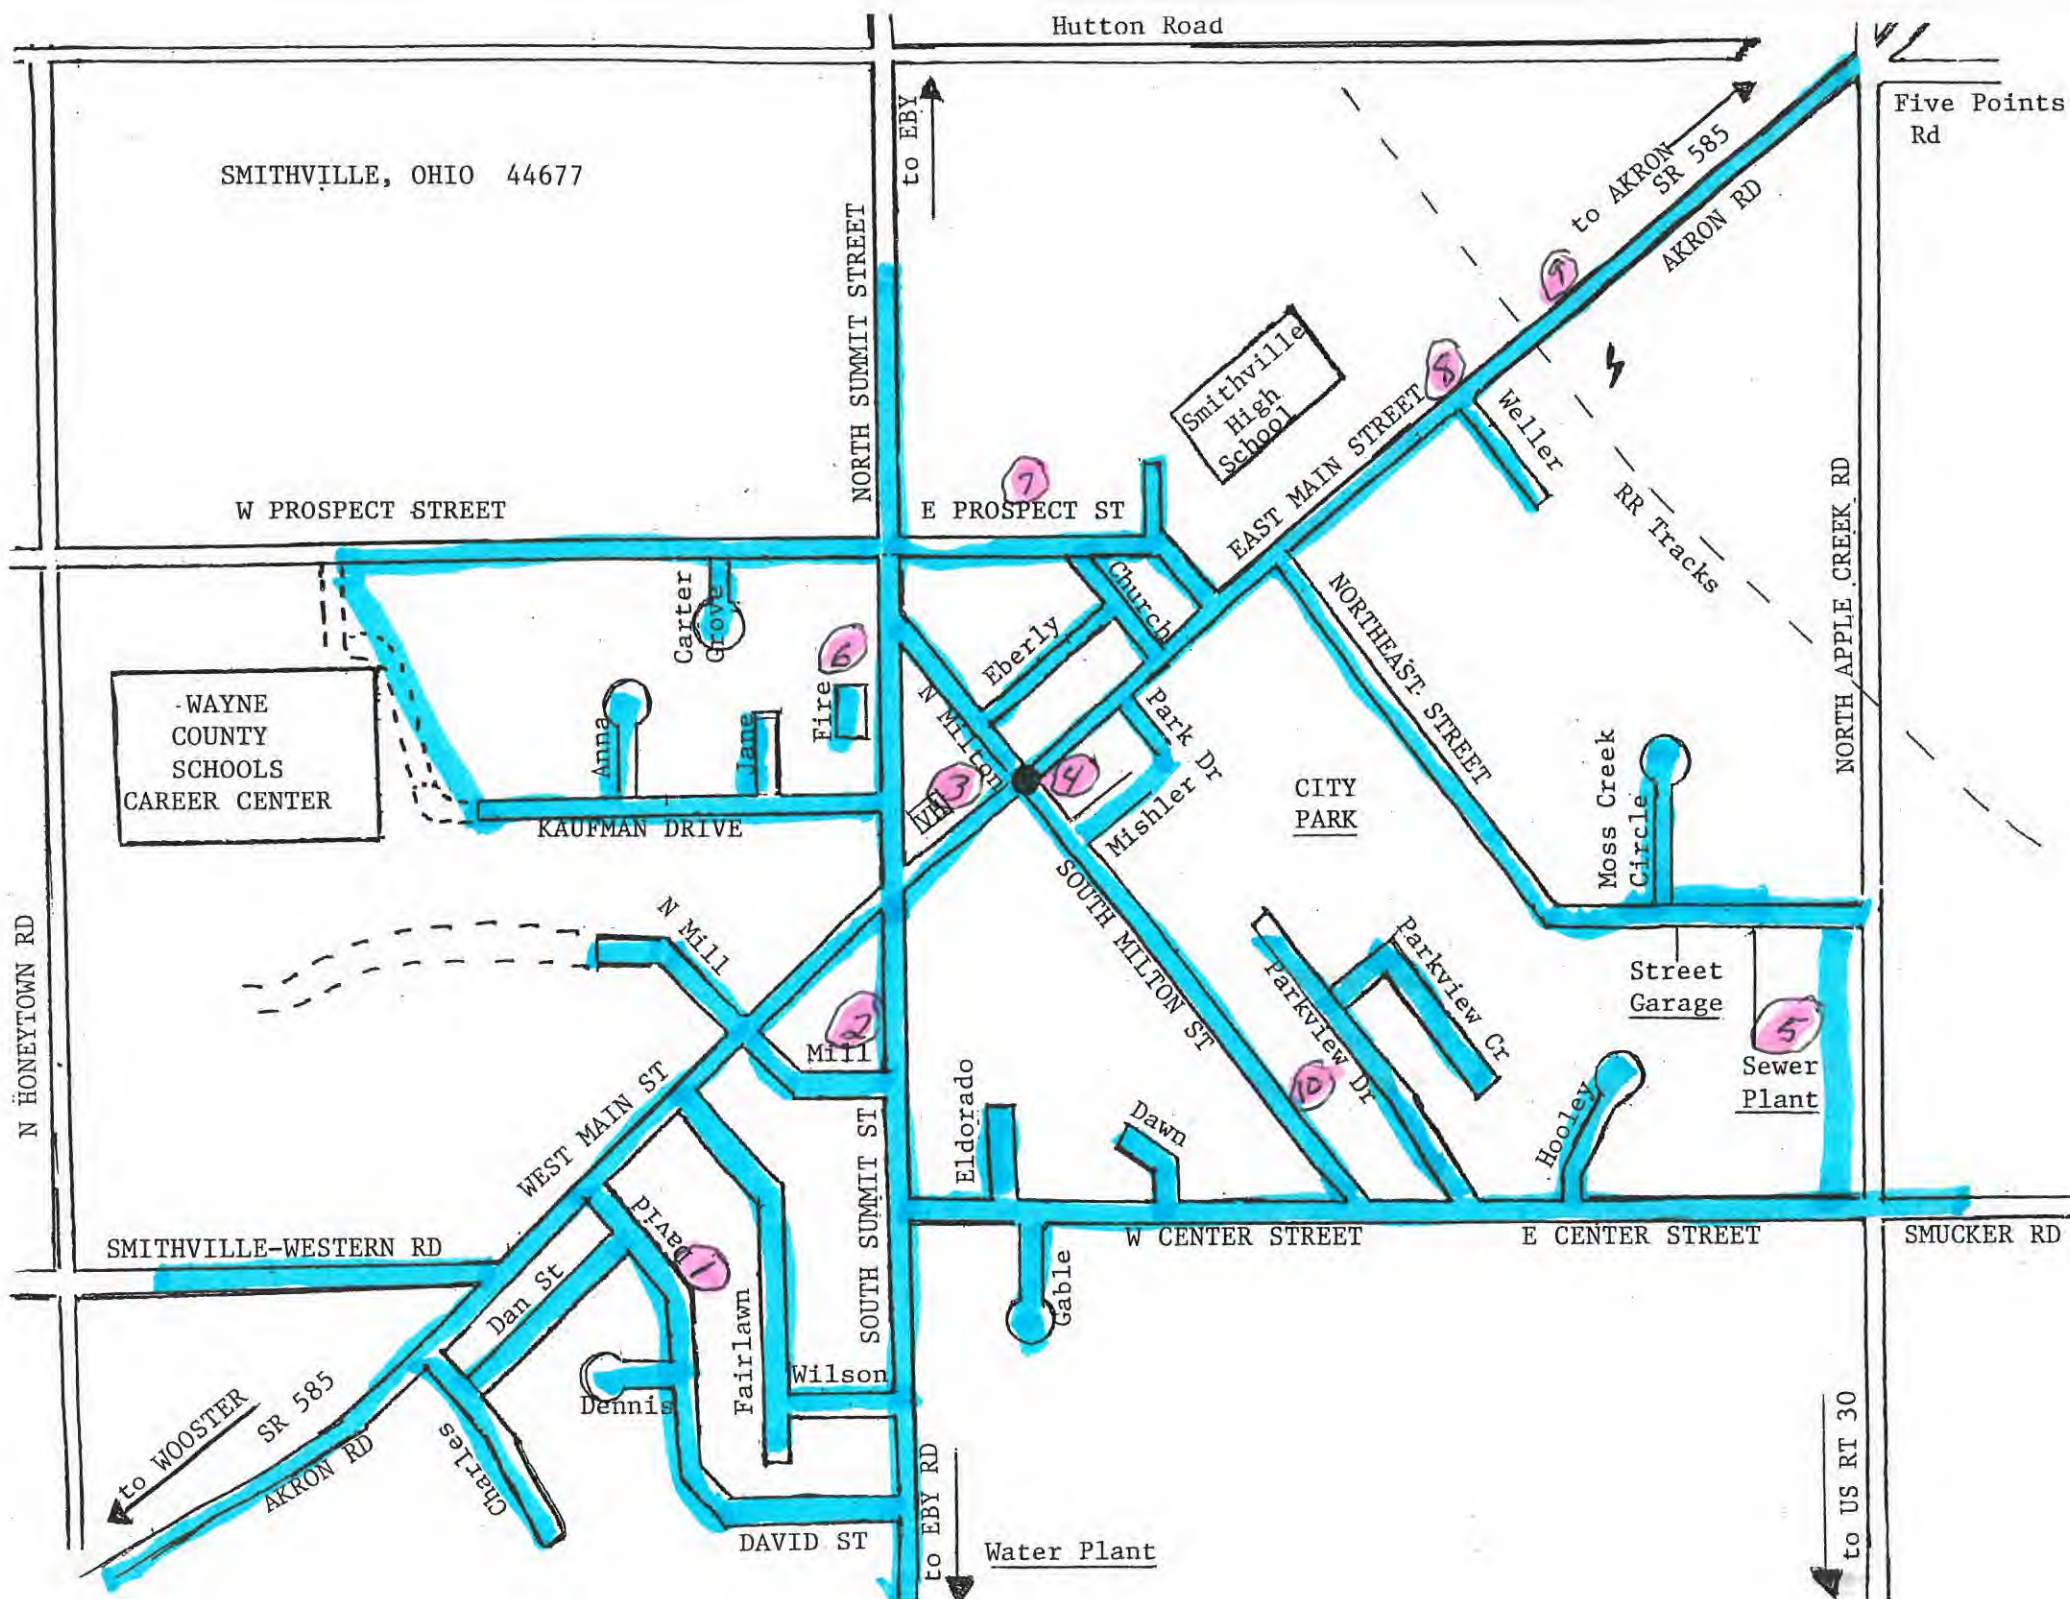

SMITHVILLE, OHIO 44677

Hutton Road

Five Points Rd

W PROSPECT STREET

NORTH SUMMIT STREET

to EBY ↑

E PROSPECT ST

Smithville High School

EAST MAIN STREET

Weller

to AKRON SR 585
AKRON RD

RR Tracks

NORTH APPLE CREEK RD

WAYNE COUNTY SCHOOLS CAREER CENTER

Carter Grove

Anna

Jane

Fire

KAUFMAN DRIVE

N MILTON

Eberly

Park Dr

SOUTH MILTON ST

NORTHEAST STREET

CITY PARK

Moss Creek Circle

Street Garage

Sewer Plant

N HONEYTOWN RD

N MILL

Mill

WEST MAIN ST

SMITHVILLE-WESTERN RD

Eldorado

Dawn

Parkview Dr

Parkview Cr

Hooley

Street Garage

W CENTER STREET

E CENTER STREET

SMUCKER RD

to WOOSTER SR 585
AKRON RD

Charles

Dan St

Dennis

Fairlawn

Wilson

DAVID ST

to EBY RD ↓

Water Plant

to US RT 30 ↓