

**VERIFICATION FORM FOR COMMUNITY PUBLIC WATER SYSTEMS
CLAIMING NO LEAD SERVICE LINES**

The owner or operator of all community public water systems must identify and map areas of their distribution system that are known or are likely to contain lead service lines. Systems must submit a copy of the applicable map to the Ohio Department of Health and the Ohio Department of Job and Family Services. Systems must also submit a report to the director containing at least both of the following: (1) The applicable map with narrative, and (2) A list of sampling locations used to collect samples as required by Ohio Revised Code (ORC) Section 6109.121 and any rules adopted thereunder, including contact information for the owner and occupant of each sampling site.

Should a water system determine no lead service lines exist in their distribution system, they must provide information stating they reviewed, at the minimum, historical permit records and local ordinances, distribution maintenance records and information pertaining to installation dates or materials for all services lines. This information must be verified below.

I HEREBY CERTIFY THAT THE FOLLOWING METHOD(S) WERE USED TO DETERMINE NO LEAD SERVICE LINES EXIST IN THIS WATER SYSTEM'S DISTRIBUTION SYSTEM, AS REQUIRED BY ORC 6109.121(F):

LEAD SERVICE LINE VERIFICATION
<p>This PWS states they have no lead service lines and has reviewed the following information (select one or more of the following): <i>TO THE BEST OF MY KNOWLEDGE! RB</i></p> <ul style="list-style-type: none"> <input type="checkbox"/> Historical permit records and/or local ordinances <input type="checkbox"/> Distribution maintenance records (i.e. meter replacement, waterline break repairs) <input checked="" type="checkbox"/> Information pertaining to installation dates for all service lines (i.e. after 1986 when lead services lines were banned) <input type="checkbox"/> Service line material of all service lines is known (i.e. all service lines are known to be PVC)

Rich Baker 7/31/17
 Signature of Responsible Person Date
Rich Baker Jr. MAINT. SUP.
 Printed Name and Title of Responsible Person

PWS NAME: WAYNE COUNTY CARE CTR
 PWS ID: OH 8504212
 COUNTY: WAYNE

<p>For Ohio EPA use only:</p> <p>Date Verification Rec'd: _____</p>
--

RECEIVED
 AUG 03 2017

Lead Mapping Verification Form Revised
 Entity: _____
 Doc Type: Report
 Doc Subtype: Lead mapping
 Program: SDAGW
 County: Wayne
 Secondary ID: OH 8504212
 Add to eDoc 587349


BY: _____

- NOTE:
- - FIRE HYDRANT
 - - WELL
 - * - TEST SITES

- * - SECRET LADIES R.R.
- * - W.C.C.C. Rm. 114
- * - W.C.C.C. Rm. 120

- * - W.C.C.C. Rm. 126
- * - W.C.C.C. AUTUMN CTR.

RECEIVED
 FEB 07 2012
 BY:

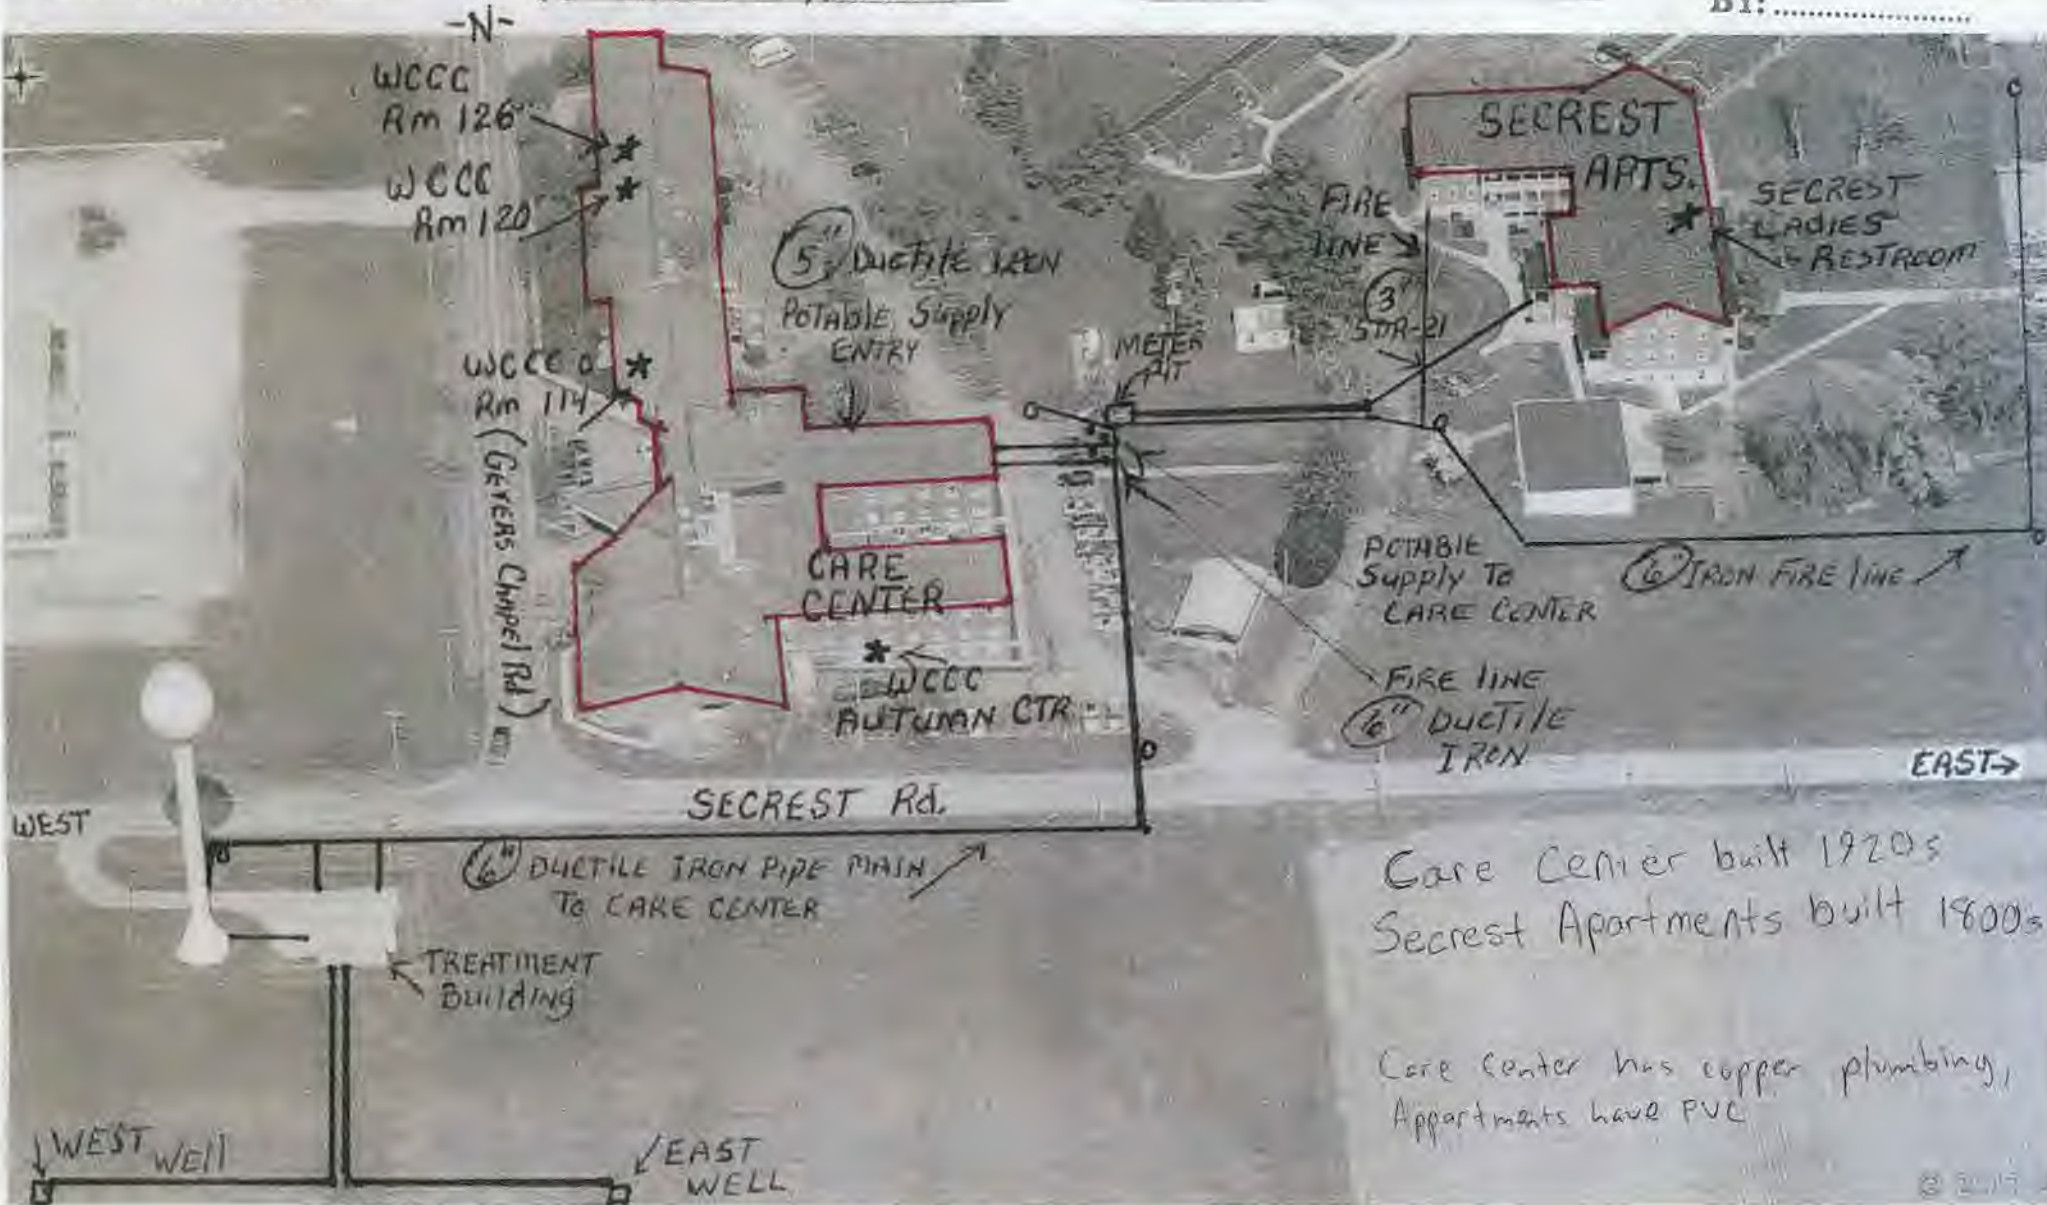


Care Center built 1920's
 Secret Apartments built 1800's
 Care Center has copper plumbing,
 Apartments have PVC

Areas outlined in RED are indicated to identify potential CHARACTERISTICS OF BUILDINGS WITH LEAD PIPING, SOLDER OR FIXTURES

- NOTE:
 ○ - FIRE HYDRANT
 □ - WELL
 * - TEST SITES

- * - SECRET LADIES R.R.
 * - W.C.C.C. Rm. 114
 * - W.C.C.C. Rm. 120

- * - W.C.C.C. Rm. 126
 * - W.C.C.C. AUTUMN CTR.

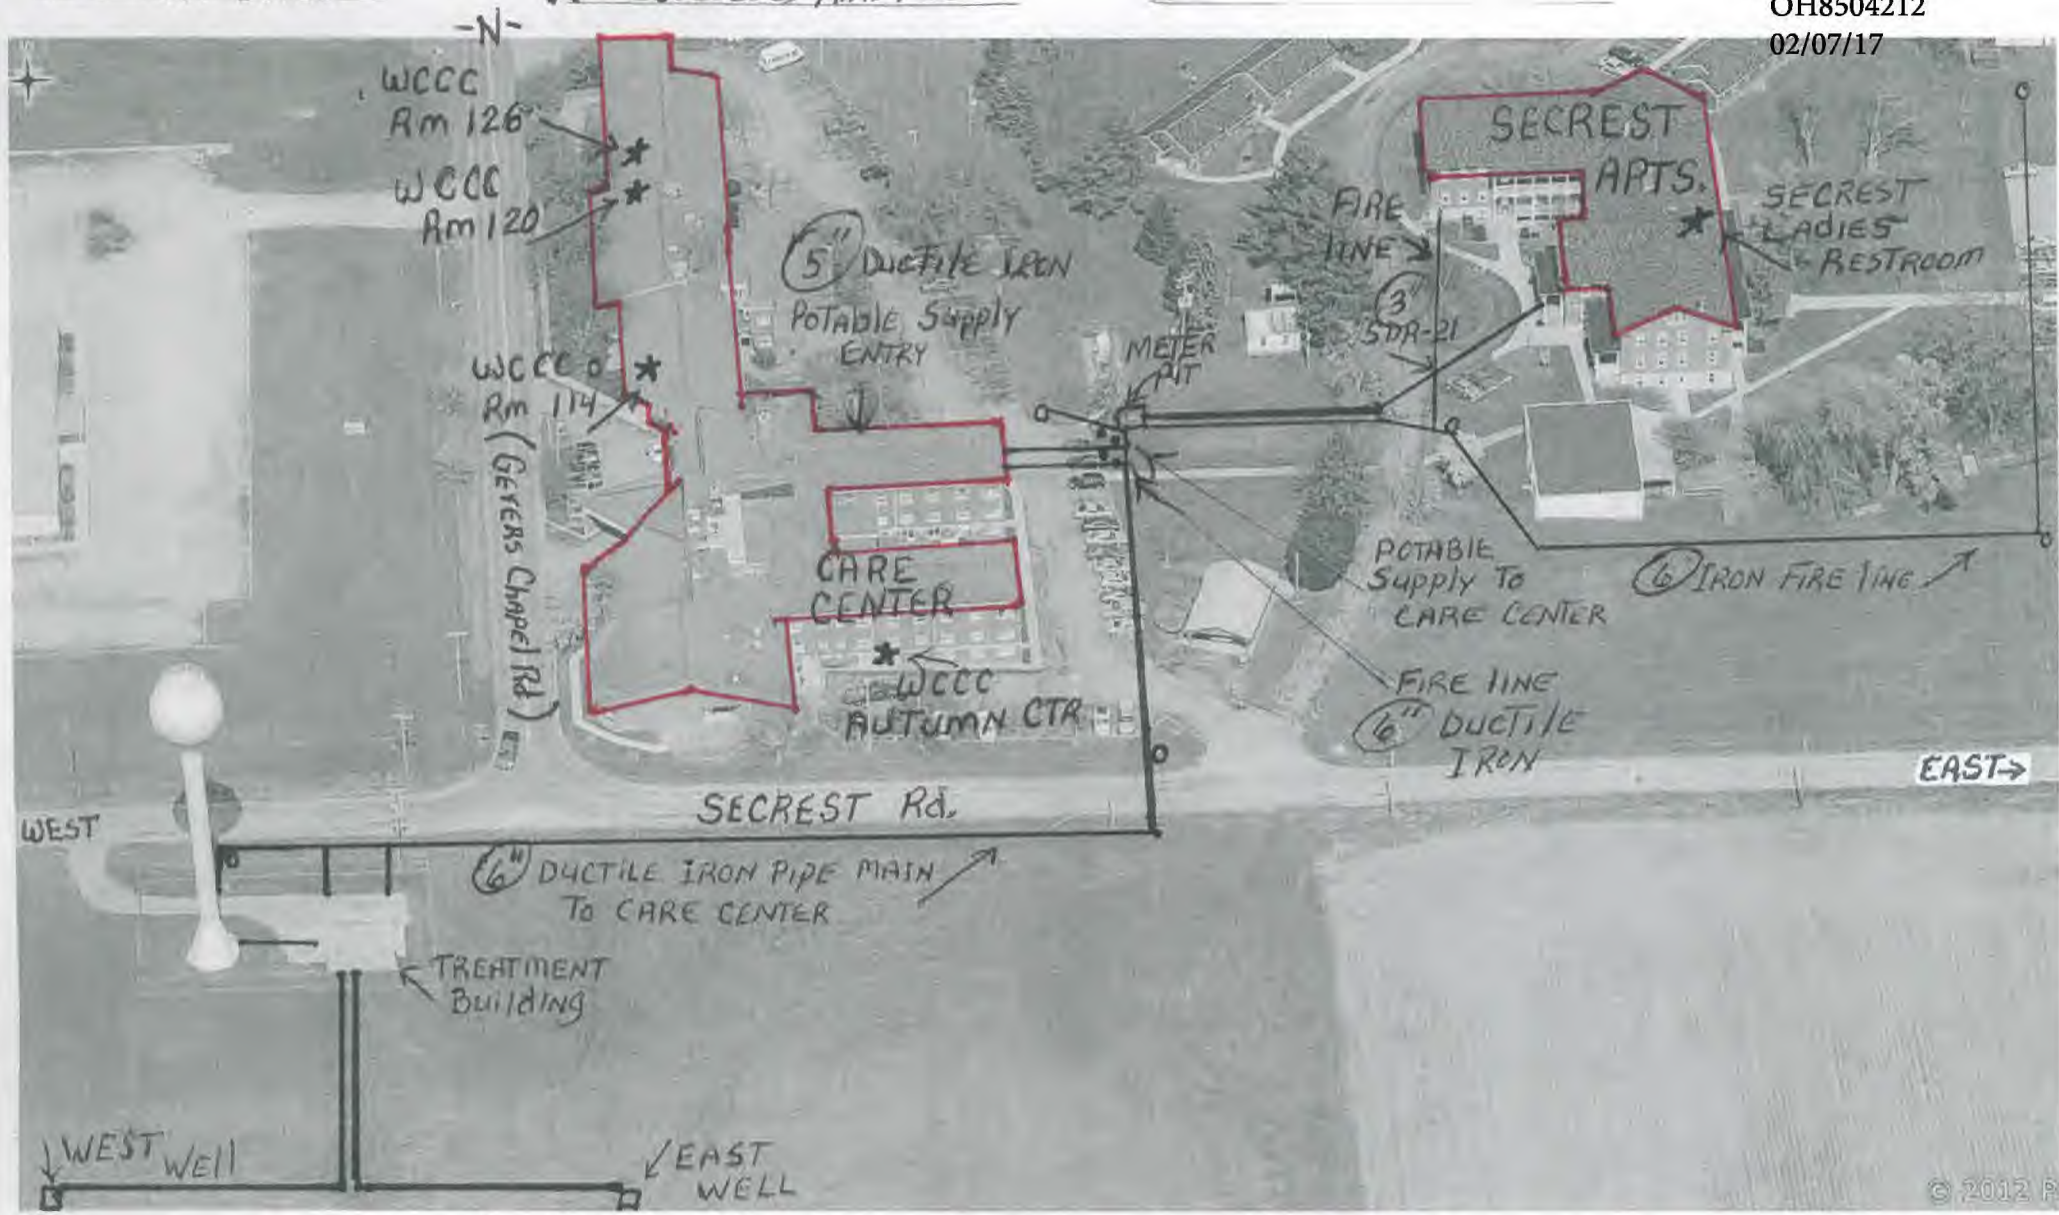

-S-