


WATER Well
PRESSURE TANK

MAPPING LEAD PLUMBING FIXTURES

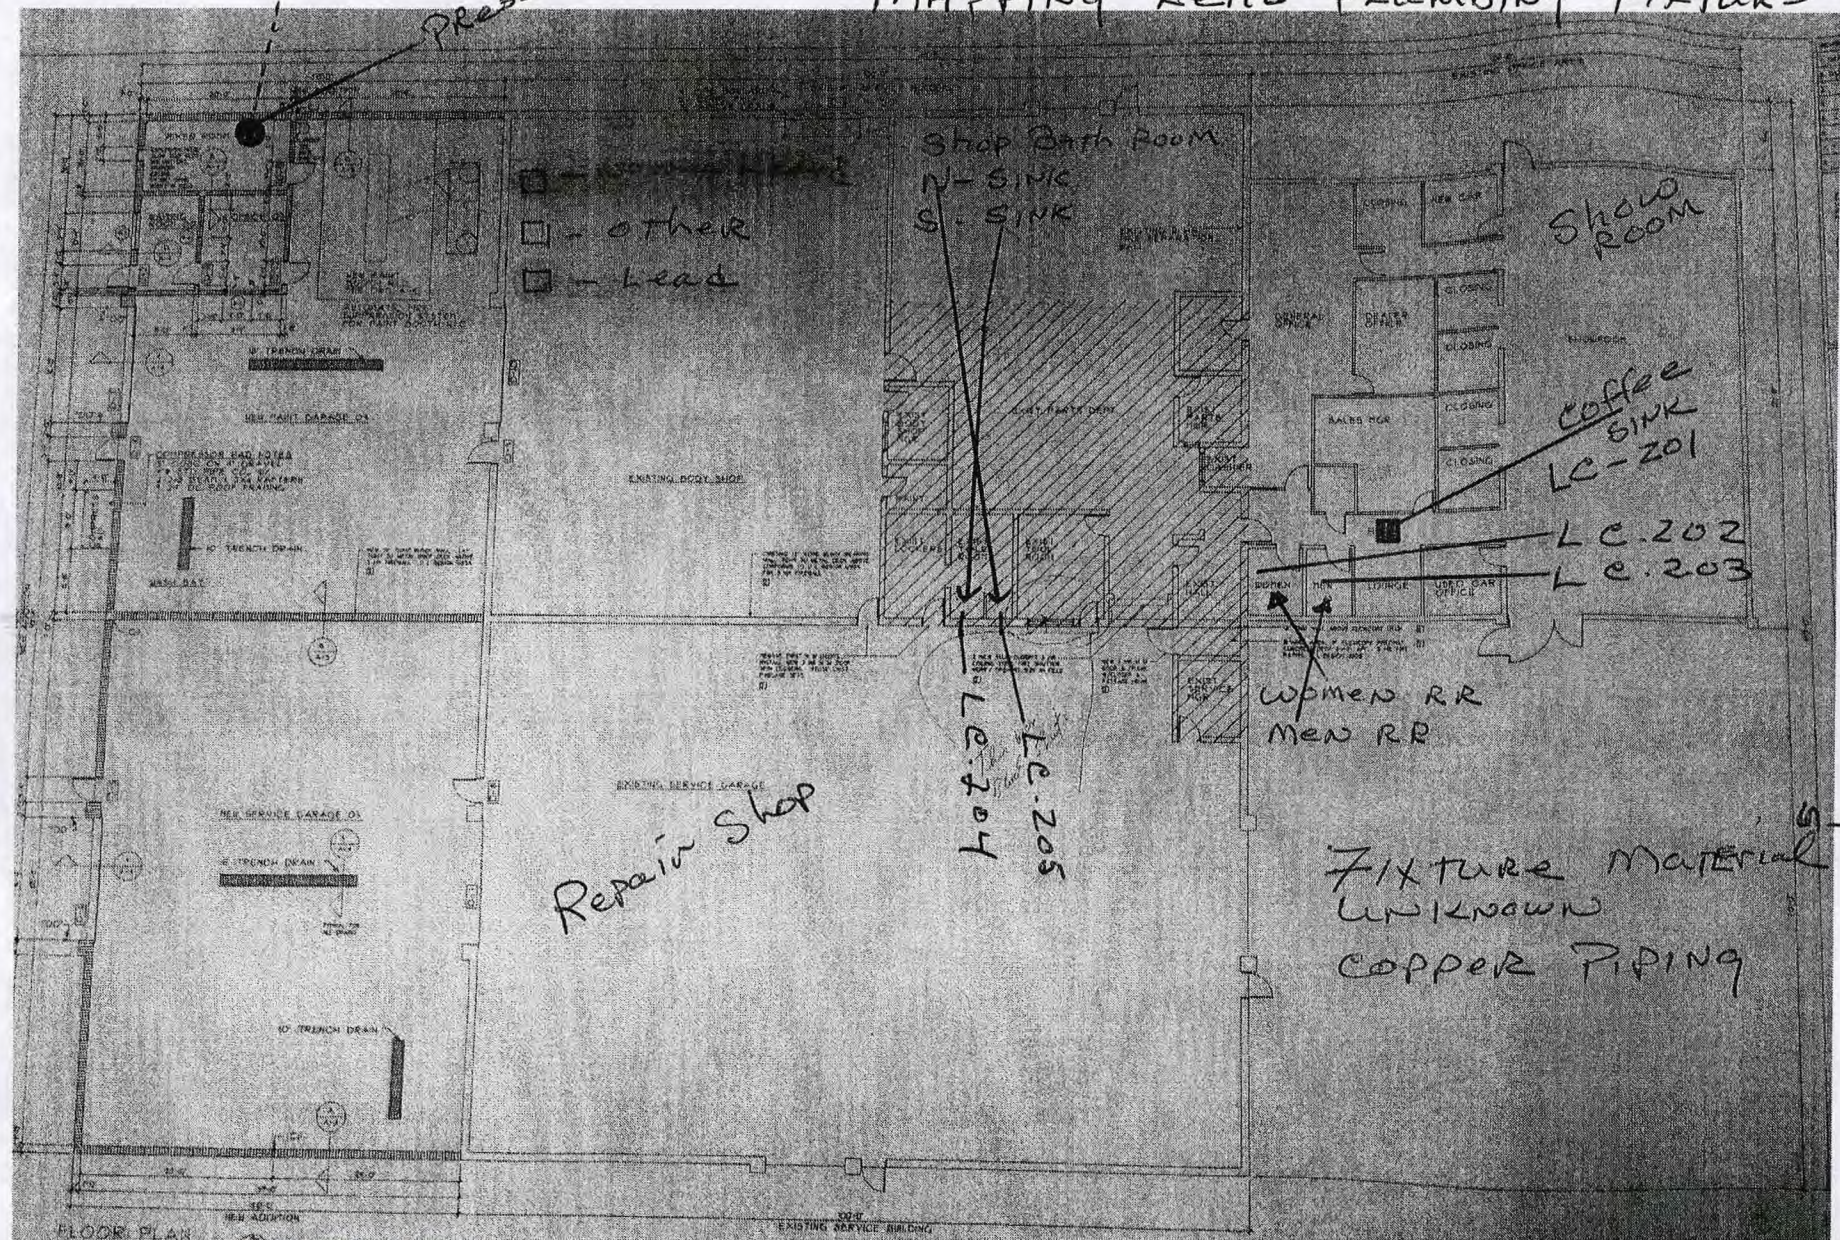

RECEIVED
JAN 16 2018
OHIO EPA NEDO

SCHONER CHEVROLET SALES
 West Maple P.O. Box 9
 HARTVILLE, Ohio 44632 PWS # OH 7642212
 330-877-4554