

Buildings built prior to 1998 or that use plumbing material or solder manufactured before 1998 may have materials with greater than 8% lead and are at a higher risk of contributing lead to the drinking water than materials manufactured after 1998. In addition, buildings built and plumbing materials manufactured after 2014 were required to have less than 0.25% lead by weight and have the lowest risk for contributing lead to the drinking water. It should be noted however that, although prohibited, some use of leaded solder or leaded components may have occurred after the prohibitions became effective

**RECEIVED**

NOV 14 2018

DDAGW - NWDO

Buildings built prior to 1998 or that use plumbing material or solder manufactured before 1998 may have materials with greater than 8% lead and are at a higher risk of contributing lead to the drinking water than materials manufactured after 1998. In addition, buildings built and plumbing materials manufactured after 2014 were required to have less than 0.25% lead by weight and have the lowest risk for contributing lead to the drinking water. It should be noted however that, although prohibited, some use of leaded solder or leaded components may have occurred after the prohibitions became effective

Read and Understand  
PWS ID# OH6334119

Roger D. Many  
VP Refrigeration, Warehouse + Facilities, Safety

11-14-2018


RECEIVED


NOV 14 2018

DDAGW NWDC

NOV 14 2018

DDAGW - NWDO

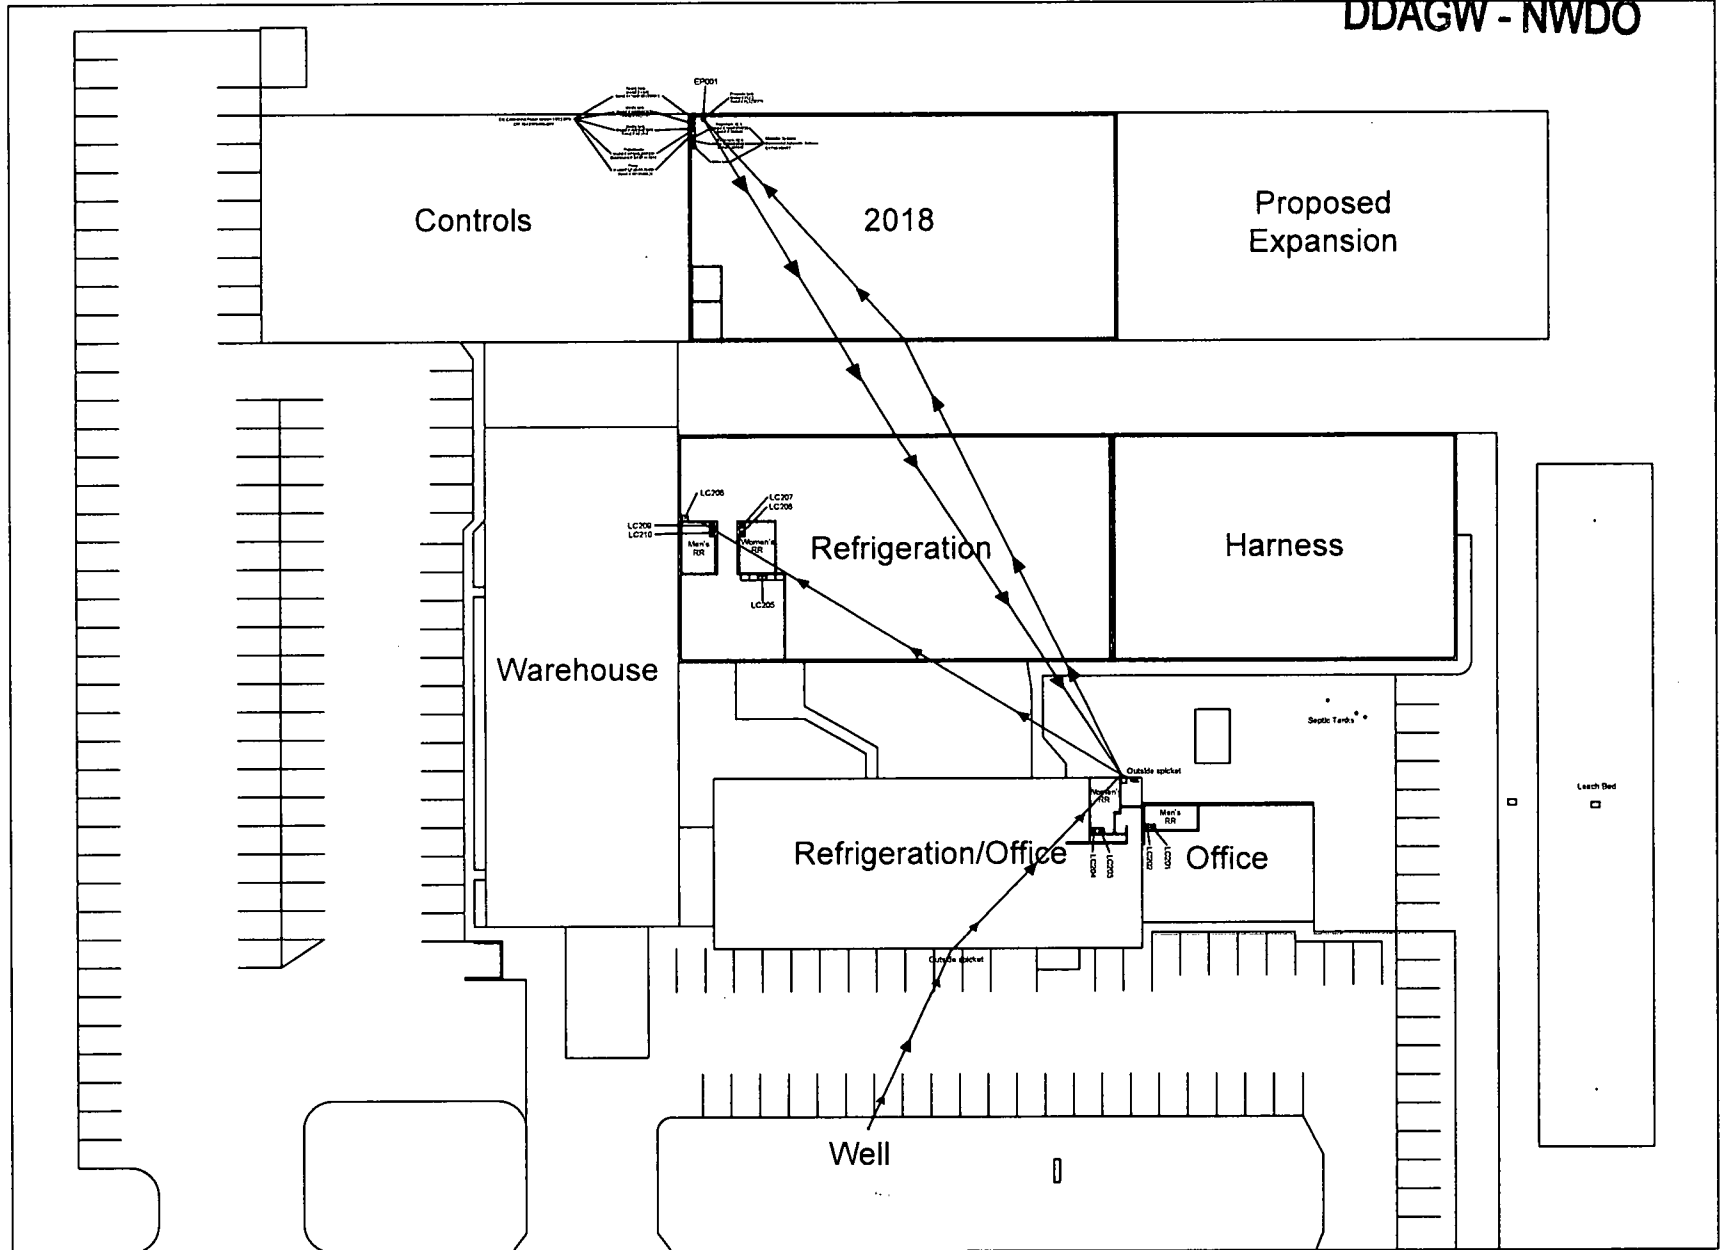

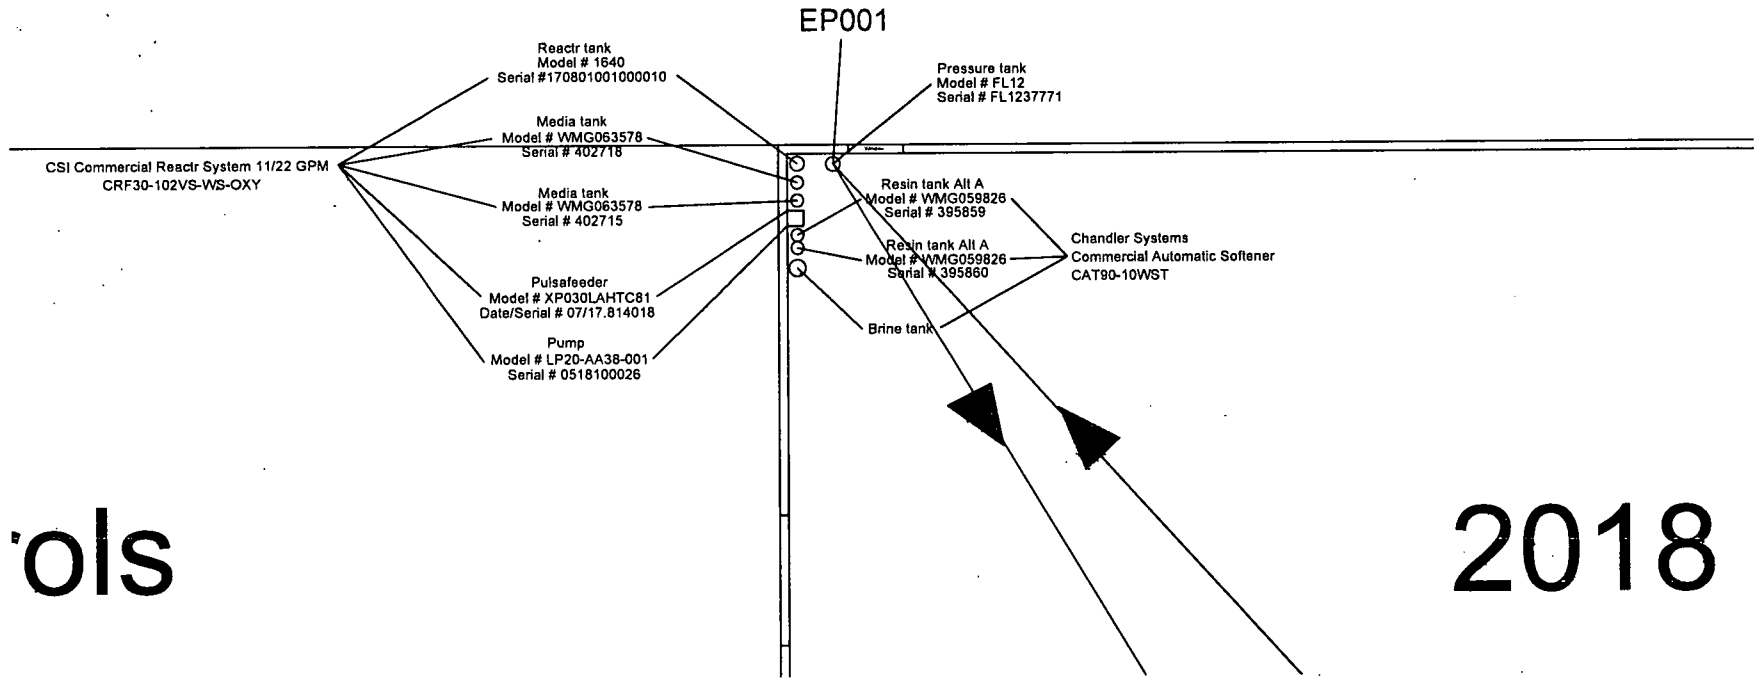


ols

2018

RECEIVED

NOV 14 2018

DDAGW - NWDO

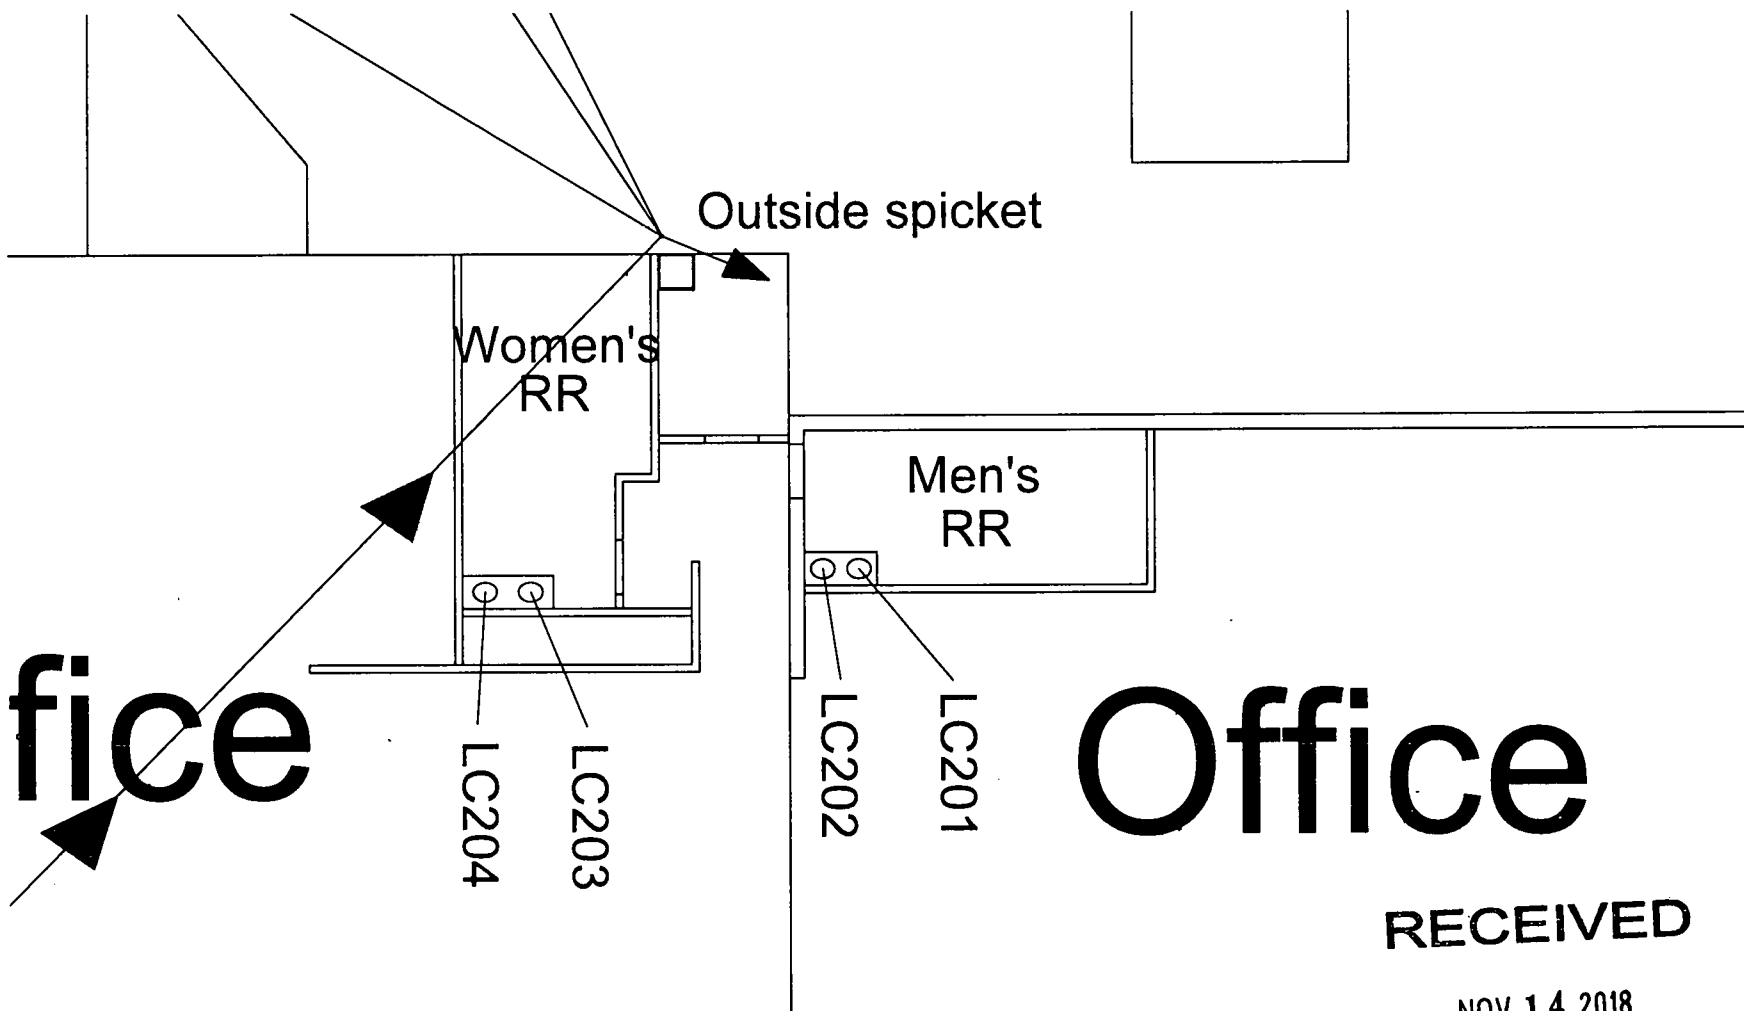


**fice**

**Office**


**RECEIVED**

NOV 14 2018

DDAGW - NWDO

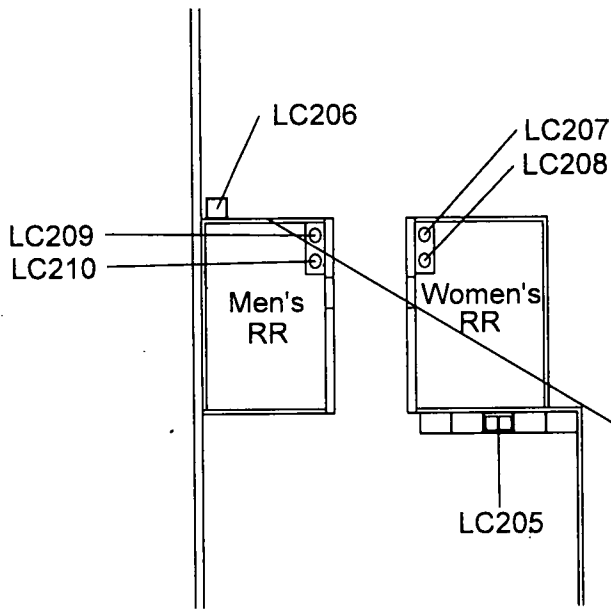

Refrigeration

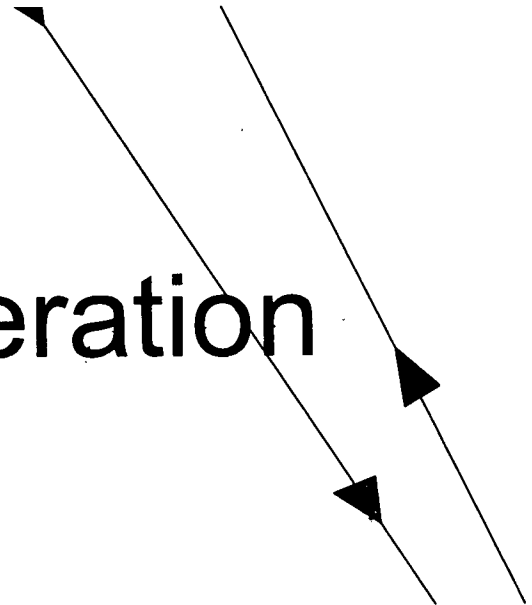

**RECEIVED**

NOV 14 2018

DDAGW - NWDO

RECEIVED

NOV 14 2018

DDAGW - NWDO

