



PROJECT NO:	022-01775-00
PROJECT MANAGER:	S. PANKRATZ
DESIGNED:	M. SAMIEC
CHECKED:	J. MARSH
© COPYRIGHT	


DRAWING TITLE:	NOI VICINITY MAP
DRAWING NO:	

PROJECT TITLE:	INTEL OHIO CAMPUS PROJECT CARDINAL
DRAWING NO:	VM-1

PROJECT NAME: INTEL OHIO CAMPUS PROJECT CARDINAL
 (11511 GREEN CHAPEL ROAD NW, NEW ALBANY, OH 43502)
 FACILITY CONTACT: KEVIN MACHCINSKI (PH: 419-255-3830/ KMACHCINSKI@GILBANECO.COM)

SITE OUTFALL

SITE OUTFALL

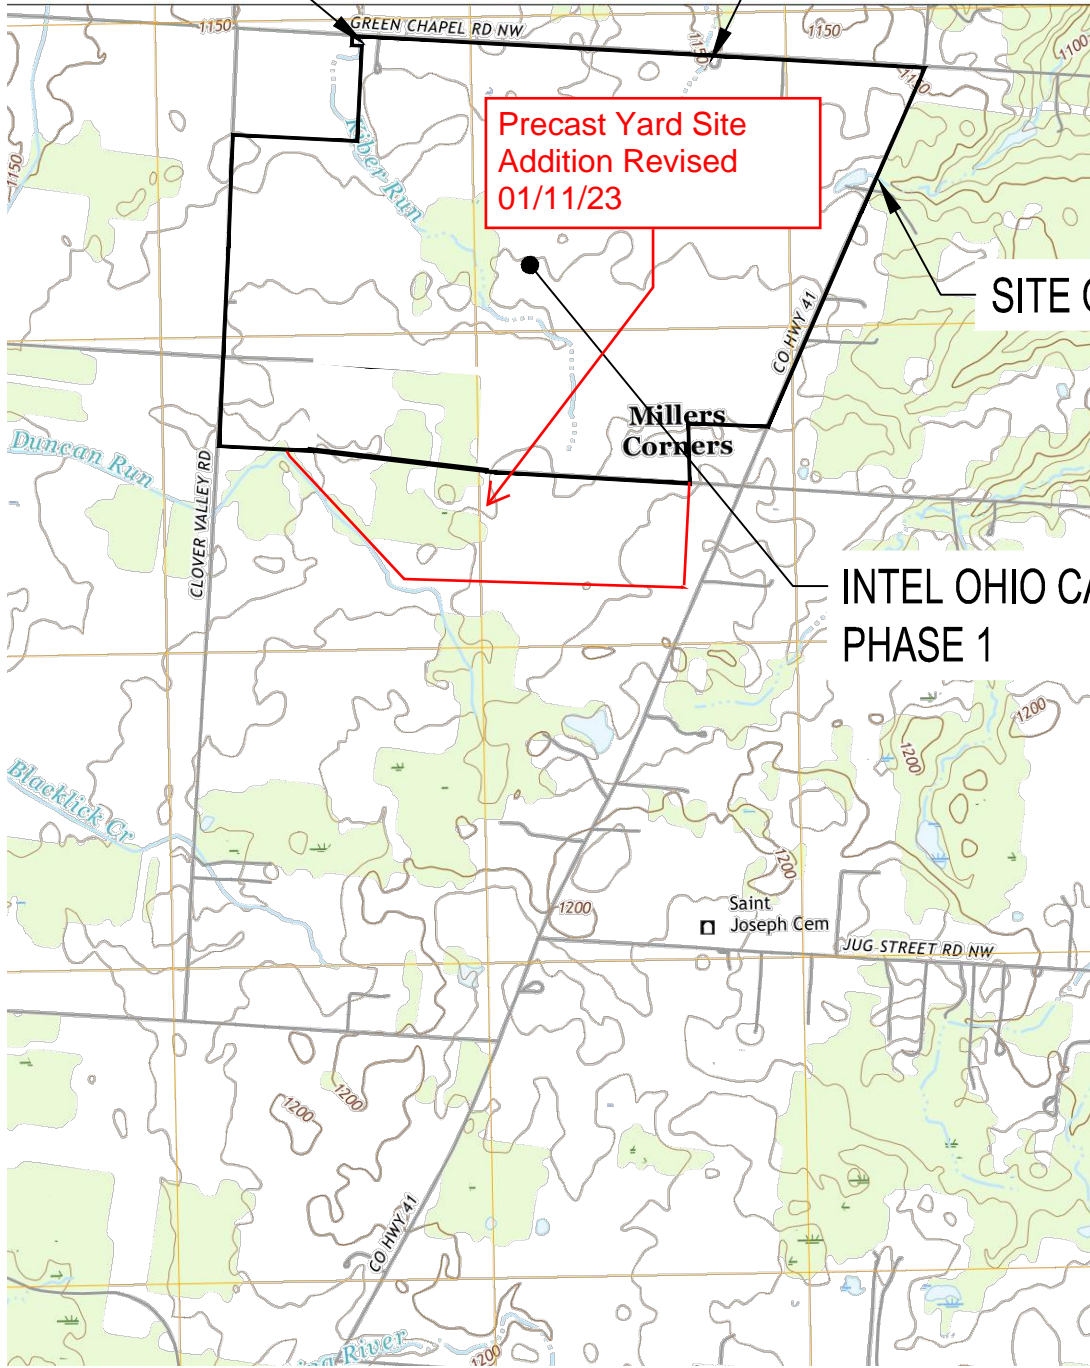

SITE OUTFALL

INTEL OHIO CAMPUS
 PHASE 1

TAKEN FROM USGS MAP
 JERSEY QUADRANGLE OHIO LICKING COUNTY
 7.5-MINUTE SERIES
 (JERSEY, OH 2019)

VICINITY MAP

NOSCALE

LIMITS OF LAND DISTURBANCE

TOTAL DISTURBED ACREAGE - - 559.5 ACRES

DATE: May 16, 2022 - 6:25pm USER: 16348 C:\Users\16348\ACCDocs\SSOE Group\Intel OH\Project Files\01_SSOE\03_Design\03_Site Enabling\20_Civil\2_Vicinity Map\NOI Vicinity Map.dwg